


Vessel Name: **Miss Karan**




PRINCIPAL PARTICULAR		PRINCIPAL DIMENSIONS	
Type of Vessel	Utility (Twin Screw)	Length (LOA)	22.5 M
Builder	Sun Contractor Inc.	Breadth	11.45 M
Built / Rebuilt	1975 / 2007 (Complete Rebuilt)	Depth	1.83 M
Flag	Bahrain	Max. Draft	
General Condition Survey	BV – Not Class	CARGO CAPACITIES	
Official No.	BN7010	Potable Water	10 MT
MMSI	40856900	Fuel Tank	10 MT
Call Sign	A9D2303	SPEED & CONSUMPTION	
Construction	Steel	Max. Speed	5 Kts.
GRT	200 T	Fuel Daily Consumption	120 liters/hour
NRT	135 T	NAVIGATION EQUIPMENT	
MACHINERY		AIS Amec	Samyung 50N
Main Engines	2 X GM V8-71 Twin Screw (Total Output: 500HP)	Radar	Furuno 1832
Main Generator	2 X GM3-71 / 3CYL/ 60KVA	Echo Sounder	Furuno LS4100
Hydraulic Crane	12 Ton Cap. (70FT)	NAVTEX Receiver	Samyung SNX-300
DECK EQUIPMENT		VHF Radio	Sailor RT2048
Anchor Winch	20 MT/200 M/36mm Wire	VHF Radio STND Horizon	Quest – GX1256S
Clear Deck	155 M2	GPS (2 nos.)	Garmin 3010C
Life Raft	E0408010	VHF Portable	Standard Horizon HX370S
MANIFEST		Magnetic Compass	Plastimo BV0062
Crew	4 Persons	EPIRB	Samyung / SEP 406


GENERAL ARRANGEMENT—MISS KARAN

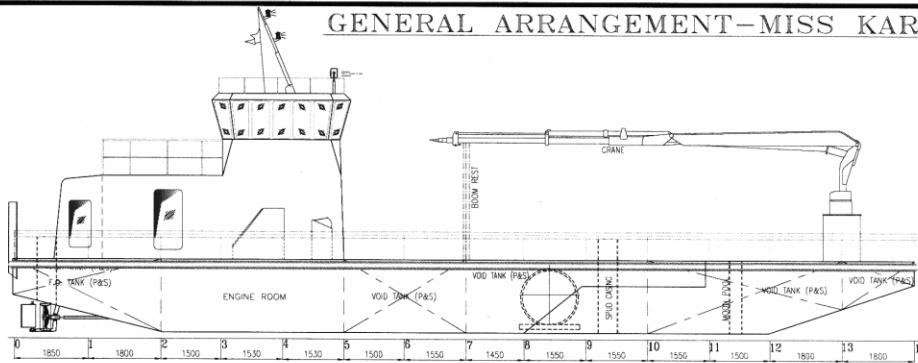


PROFILE VIEW

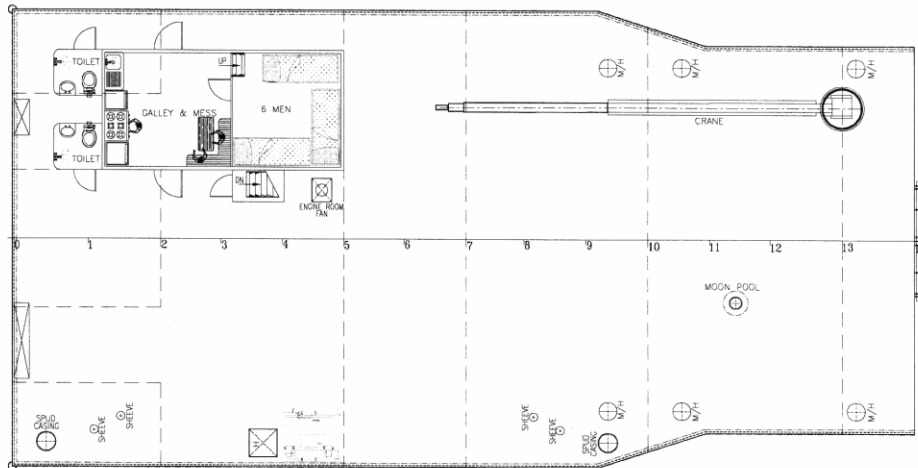

MAIN DECK PLAN

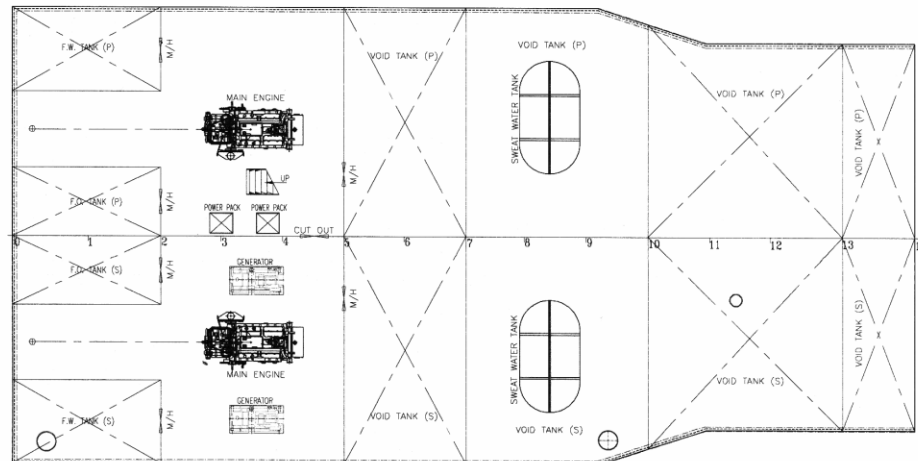

BOTTOM PLAN

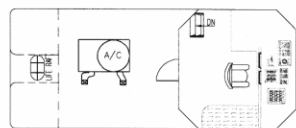

WHEEL HOUSE

PRINCIPAL PARTICULARS

LENGTH : 22.50 m
 BREADTH : 11.45 m
 DEPTH : 01.83 m

MISS KARAN

0	20.12.12	INITIAL ISSUE	-	NKV
REV	DATE	DESCRIPTION	REVISED BY	APPROVED

REVISIONS



ARIES MARINE & ENGG. SERVICES
 P.O. BOX - 24496, SHARJAH, U.A.E.
 Tel: 00971(0)6 5614166, Fax: 00971(0)6 5614167
 Website: www.ariesmvt.com, Email: design@ariesgroup.ae

This drawing, design concept, and specifications are the property of **ARIES MARINE & ENGG. SERVICES** and are furnished on a confidential basis with an expressed understanding that they will not be copied in any manner, used for manufacture, sold, transferred, nor used to the detriment of said firm without written permission. The recipient further agrees not to disclose these contents hereof to any other parties except for those specific purposes for which this drawing was issued.

TITLE: GENERAL ARRANGEMENT			
AS BUILT			
VESSEL NAME : MISS KARAN	DATE : 20.12.12	DWG. No : DN8662/201	
DRAWN BY : APR	JOB No : DN8662	SHEET : 01 OF 01	
CHECKED BY : DD	SCALE : 1:75	REV : 0	SIZE : A2